

Application to the HISTORIC DISTRICT COMMISSION, Nantucket, Massachusetts, for a

CERTIFICATE OF APPROPRIATENESS

for structural work.

All blanks must be filled in using BLUE OR BLACK INK (no pencil) or marked N/A.

NOTE: It is strongly recommended that the applicant be familiar with the HDC guidelines, *Building with Nantucket in Mind*, prior to submittal of application. Please see other side for submittal requirements. Incomplete applications will not be reviewed by the HDC.

This is a contractual agreement and must be filled out in ink. An application is hereby made for issuance of a Certificate of Appropriateness under Chapter 395 of the Acts and Resolves of Mass., 1970, for proposed work as described herein and on plans, drawings and photographs accompanying this application and made a part hereof by reference.

The certificate is valid for three years from date of issuance. No structure may differ from the approved application. Violation may impede issuance of Certificate of Occupancy.

PROPERTY DESCRIPTION

TAX MAP N°: 67 PARCEL N°: 703
Street & Number of Proposed Work: 10 FIFTH WAY
Owner of record: CHRISTINE ALLEN
Mailing Address: 1220 OCEAN AVENUE
N. ST PETERSBURG, FL. 33709
Contact Phone #: (800) 221-1534 E-mail: CWO@CENTEXTEL.NET

AGENT INFORMATION (if applicable)

Name: WENDY WETHERILL
Mailing Address: 10 FIFTH WAY
NANTUCKET, MA 02554
Contact Phone #: (508) 680-4382 E-mail: WETHERILL@GMAIL.COM

FOR OFFICE USE ONLY

Date application received: _____ Fee Paid: \$ _____
Must be acted on by: _____
Extended to: _____
Approved: _____ Disapproved: _____
Chairman: _____
Member: _____
Member: _____
Member: _____
Member: _____
Notes - Comments - Restrictions - Conditions

DESCRIPTION OF WORK TO BE PERFORMED
See reverse for required documentation.

New Dwelling Addition Garage Driveway/Apron Commercial Historical Renovation Deck/Patio Steps Shed
 Color Change Fence Gate Hardscaping Move Building Demolition Revisions to previous Cert. No. 59180
 Pool (Zoning District _____) Roof Other: SKYLIGHTS (Add skylights) Add skylights & window size changes
Size of Structure or Addition: Length: _____ Sq. Footage 1st floor: _____ Decks/Patio: Size: N/C 1st floor 2nd floor
Width: N/C Sq. Footage 2nd floor: _____ Size: _____ 1st floor 2nd floor
Sq. Footage 3rd floor: _____

Difference between existing grade and proposed finish grade: North _____ South _____ East _____ West _____
Height of ridge above final finish grade: North N/C South N/C East N/C West N/C

Additional Remarks

Historic Name: _____
Original Date: _____ (describe)
Original Builder: _____
Is there an HDC survey form for this building attached? Yes N/A

REVISIONS:

- 1. East Elevation - "AS BUILT"
- 2. South Elevation
- 3. West Elevation
- 4. North Elevation

*Cloud on drawings and submit photographs of existing elevations.

DETAIL OF WORK TO BE PERFORMED

Foundation: Height Exposed N/C Block Block Parged Brick (type) _____ Poured Concrete Piers
Masonry Chimney: Block Parged Brick (type) _____ Other _____
Roof Pitch: Main Mass N/C /12 Secondary Mass _____ /12 Dormer _____ /12 Other _____

Roofing material: Asphalt: 3-Tab Architectural
 Wood (Type: Red Cedar, White Cedar, Shakes, etc.) _____

Fence: Height: _____
Type: _____
Length: _____

Skylights (flat only): Manufacturer VWVX Rough Opening _____ Size 2x3 Location EAST
Manufacturer VWVX Rough Opening _____ Size 2x3 Location EAST

Gutters: Wood Aluminum Copper Leaders (material) _____

Leaders (material and size): _____

Sidewall: White cedar shingles _____ Clapboard (exposure: _____ inches) Front Side
 Other _____

Trim: A. Wood Pine Redwood Cedar Other _____

B. Treatment Paint Natural to weather Other _____

C. Dimensions: Fascia 1x4 Rake 1x8 Soffit (Overhang) _____ Corner boards 1x4 Frieze _____

Window Casing 1x4 Door Frame 1x4 Columns/Posts: Round _____ Square _____

Windows*: Double Hung Casement All Wood Other _____

True Divided Lights (muntins), single pane SDL's (Simulated Divided Lights) Manufacturer: EAST WITH STORM

Doors* (type and material): TDL SDL Front: COLOMBIA Rear: N/C Side: 9 ft.

Garage Door(s): Type _____ Material _____

Hardscape materials: Driveways _____ Walkways _____ Walls _____

* Note: Complete door and window schedules are required.

COLORS

Sidewall NATURAL Clapboard (if applicable) _____ Roof HANNOVER GRAYS
Trim NATURAL Sash WHITE Doors WHITE
Deck NATURAL Foundation GRAY Fence _____ Shutters _____



* Attach manufacturer's color samples if color is not from HDC approval list.

I hereby authorize the agent named above to act on my behalf to make changes in the specifications or the plans contained in this application in order to bring the application into compliance with the HDC guidelines. I hereby agree to abide by and comply with the terms and conditions of this application. I hereby agree that the submission of any revisions to this application will initiate a new sixty-day review period.

Date 5/11/16 Signature of owner of record Wendy Wetherill Murrain Signed under penalties of perjury


2016 MAY 11 AM 11:05
2016 MAY 11 AM 11:04

As built

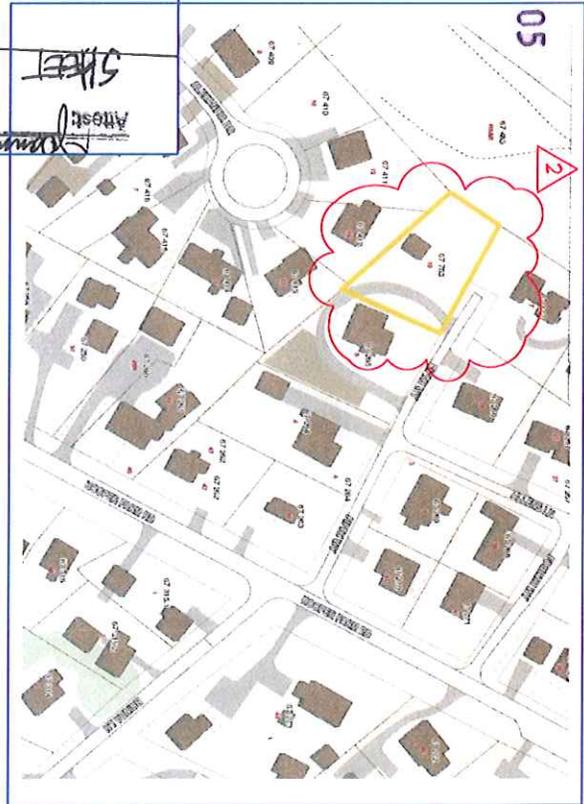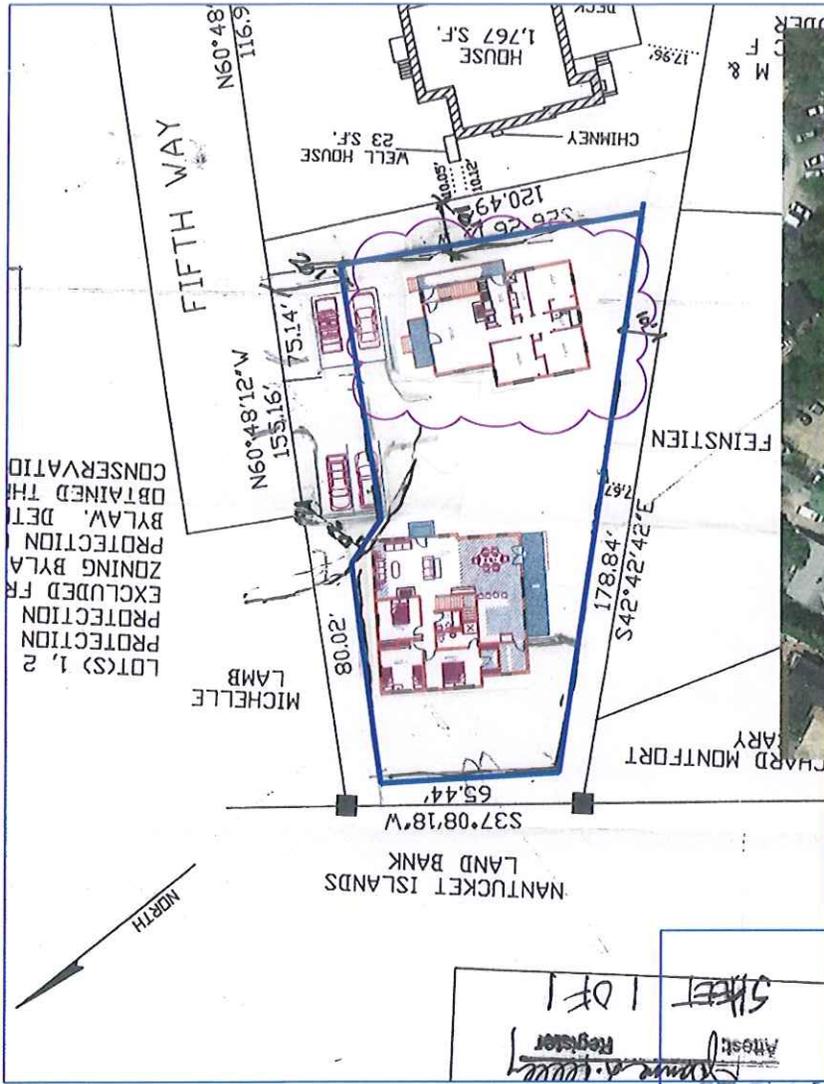


AS BUILT REVISIONS FOR CHRISTINE OUREN
 FOR "GULL" HOUSE
 10 FIFTH WAY

SCALE: 1/4"=1'
 DRAWN BY: VO
 DATE: 5-11-16 REV

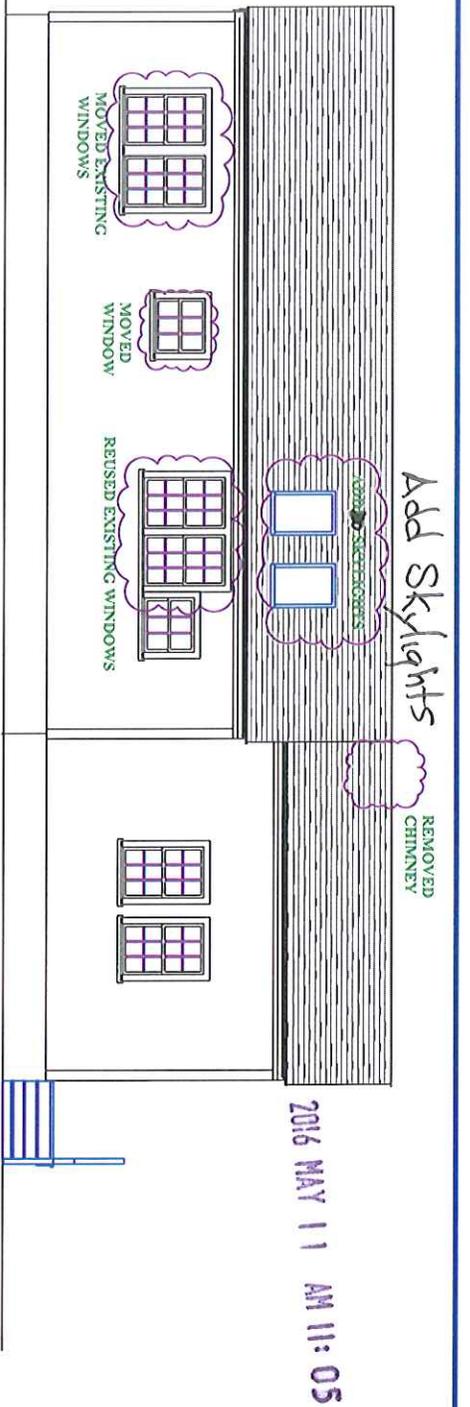

EXISTING NORTH ELEVATION

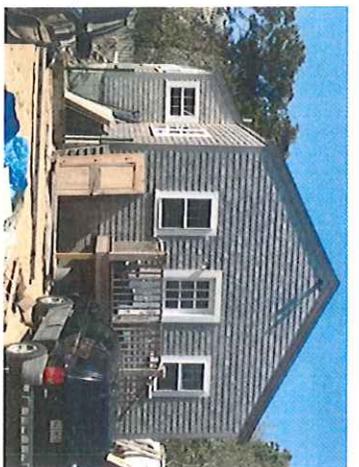


EAST ELEVATION



EXISTING EAST ELEVATION



Reduced window size in shower
enlarged the double window

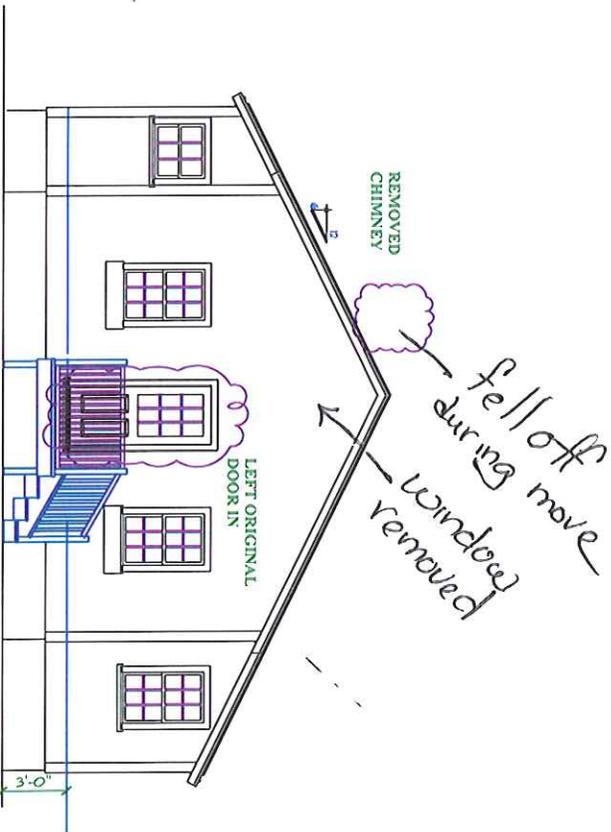

NORTH FACING FIFTH WAY

**AS BUILT REV PER CHRISTINE OUREN
 "GULL" HOUSE ON 10 FIFTH WAY**