

CERTIFICATE NO: \_\_\_\_\_

DATE ISSUED: \_\_\_\_\_

Application to the HISTORIC DISTRICT COMMISSION, Nantucket, Massachusetts, for a

**CERTIFICATE OF APPROPRIATENESS**

for structural work.

All blanks must be filled in using BLUE OR BLACK INK (no pencil) or marked N/A.

**NOTE: It is strongly recommended that the applicant be familiar with the HDC guidelines, *Building with Nantucket in Mind*, prior to submittal of application. Please see other side for submittal requirements. Incomplete applications will not be reviewed by the HDC.**

This is a contractual agreement and must be filled out in ink. An application is hereby made for issuance of a Certificate of Appropriateness under Chapter 395 of the Acts and Resolves of Mass., 1970, for proposed work as described herein and on plans, drawings and photographs accompanying this application and made a part hereof by reference.

The certificate is valid for three years from date of issuance. No structure may differ from the approved application. Violation may impede issuance of Certificate of Occupancy.

**PROPERTY DESCRIPTION**

TAX MAP N°: 74 PARCEL N°: 24  
Street & Number of Proposed Work: 6 SWEETWING CIRCLE  
Owner of record: CANNONBURY LANE HOLDINGS 2, LLC  
Mailing Address: 105 NEWBURY ST, 4TH FLOOR  
BOSTON, MA 02116  
Contact Phone #: \_\_\_\_\_ E-mail: \_\_\_\_\_

**AGENT INFORMATION (if applicable)**

Name: AHERN LLC  
Mailing Address: 6 WINDY WAY, NANTUCKET, MA 02554  
Contact Phone #: 508-333-5738 E-mail: DESIGN@AHERNLLC.COM

**FOR OFFICE USE ONLY**

Date application received: \_\_\_\_\_ Fee Paid: \$ \_\_\_\_\_  
Must be acted on by: \_\_\_\_\_  
Extended to: \_\_\_\_\_  
Approved: \_\_\_\_\_ Disapproved: \_\_\_\_\_  
Chairman: \_\_\_\_\_  
Member: \_\_\_\_\_  
Member: \_\_\_\_\_  
Member: \_\_\_\_\_  
Member: \_\_\_\_\_  
Notes - Comments - Restrictions - Conditions  
\_\_\_\_\_  
\_\_\_\_\_

**DESCRIPTION OF WORK TO BE PERFORMED**

See reverse for required documentation.

- New Dwelling  Addition  Garage  Driveway/Apron  Commercial  Historical Renovation  Deck/Patio  Steps  Shed
- Color Change  Fence  Gate  Hardscaping  Move Building  Demolition  Revisions to previous Cert. No. \_\_\_\_\_
- Pool (Zoning District \_\_\_\_\_)  Roof  Other \_\_\_\_\_

Size of Structure or Addition: Length: \_\_\_\_\_ Sq. Footage 1st floor: \_\_\_\_\_ Beeks/Patio: Size: 260 SF  1st floor  2nd floor  
Width: \_\_\_\_\_ Sq. Footage 2nd floor: \_\_\_\_\_ Size: \_\_\_\_\_  1st floor  2nd floor  
Sq. Footage 3rd floor: \_\_\_\_\_

Difference between existing grade and proposed finish grade: North \_\_\_\_\_ South \_\_\_\_\_ East \_\_\_\_\_ West \_\_\_\_\_  
Height of ridge above final finish grade: North \_\_\_\_\_ South \_\_\_\_\_ East \_\_\_\_\_ West \_\_\_\_\_

**Additional Remarks**

Historic Name: \_\_\_\_\_  
Original Date: \_\_\_\_\_  
Original Builder: \_\_\_\_\_  
Is there an HDC survey form for this building attached?  Yes  N/A

- REVISIONS\***
- 1. East Elevation
  - 2. South Elevation
  - 3. West Elevation
  - 4. North Elevation

\*Cloud on drawings and submit photographs of existing elevations.

**DETAIL OF WORK TO BE PERFORMED**

Foundation: Height Exposed \_\_\_\_\_  Block  Block Parged  Brick (type) \_\_\_\_\_  Poured Concrete  Piers  
Masonry Chimney:  Block Parged  Brick (type) \_\_\_\_\_  Other \_\_\_\_\_  
Roof Pitch: Main Mass \_\_\_\_\_/12 Secondary Mass \_\_\_\_\_/12 Dormer \_\_\_\_\_/12 Other \_\_\_\_\_  
Roofing material:  Asphalt:  3-Tab  Architectural  
 Wood (Type: Red Cedar, White Cedar, Shakes, etc.) \_\_\_\_\_

Fence: Height: \_\_\_\_\_  
Type: \_\_\_\_\_  
Length: \_\_\_\_\_

Skylights (flat only): Manufacturer \_\_\_\_\_ Rough Opening \_\_\_\_\_ Size \_\_\_\_\_ Location \_\_\_\_\_  
Manufacturer \_\_\_\_\_ Rough Opening \_\_\_\_\_ Size \_\_\_\_\_ Location \_\_\_\_\_

Gutters:  Wood  Aluminum  Copper  Leaders (material) \_\_\_\_\_  
Leaders (material and size): \_\_\_\_\_

Sidewall:  White cedar shingles \_\_\_\_\_  Clapboard (exposure: \_\_\_\_\_ inches) Front  Side   
 Other \_\_\_\_\_

Trim: A. Wood  Pine  Redwood  Cedar  Other \_\_\_\_\_  
B. Treatment  Paint  Natural to weather  Other \_\_\_\_\_

C. Dimensions: Fascia \_\_\_\_\_ Rake \_\_\_\_\_ Soffit (Overhang) \_\_\_\_\_ Corner boards \_\_\_\_\_ Frieze \_\_\_\_\_  
Window Casing \_\_\_\_\_ Door Frame \_\_\_\_\_ Columns/Posts: Round \_\_\_\_\_ Square \_\_\_\_\_

Windows\*:  Double Hung  Casement  All Wood  Other \_\_\_\_\_  
 True Divided Lights(muntlins), single pane  SDL's (Simulated Divided Lights) Manufacturer \_\_\_\_\_

Doors\* (type and material):  TDL  SDL Front \_\_\_\_\_ Rear \_\_\_\_\_ Side \_\_\_\_\_  
Garage Door(s): Type \_\_\_\_\_ Material \_\_\_\_\_

Hardscape materials: Driveways PEA STONE Walkways BLUE STONE Walls \_\_\_\_\_

\* Note: Complete door and window schedules are required. PATIO: BLUE STONE APRON: BELGIUM BLOCK

**COLORS**

Sidewall \_\_\_\_\_ Clapboard (if applicable) \_\_\_\_\_ Roof \_\_\_\_\_  
Trim \_\_\_\_\_ Sash \_\_\_\_\_ Doors \_\_\_\_\_  
Deck \_\_\_\_\_ Foundation \_\_\_\_\_ Fence \_\_\_\_\_ Shutters \_\_\_\_\_

\* Attach manufacturer's color samples if color is not from HDC approval list.

I hereby authorize the agent named above to act on my behalf to make changes in the specifications or the plans contained in this application in order to bring the application into compliance with the HDC guidelines. I hereby agree to abide by and comply with the terms and conditions of this application. I hereby agree that the submission of any revisions to this application will initiate a new sixty-day review period.

Date: 8-25-2020

Signature of owner of record \_\_\_\_\_


Signed under penalties of perjury



OLD MAP / PARCEL # 24 / 24




AERIAL MAP / PARCEL # 24 / 24

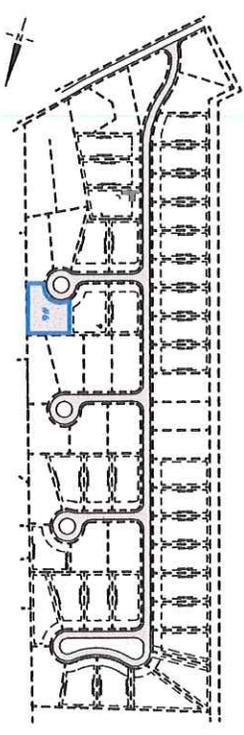

CANNONSBRURY DRIVE PLAN


SCALE: 1" = 20'

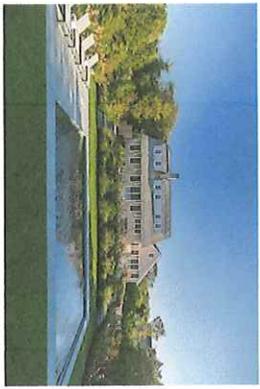

BLUE STONE PATIO



BELGIUM BLOCK APRON

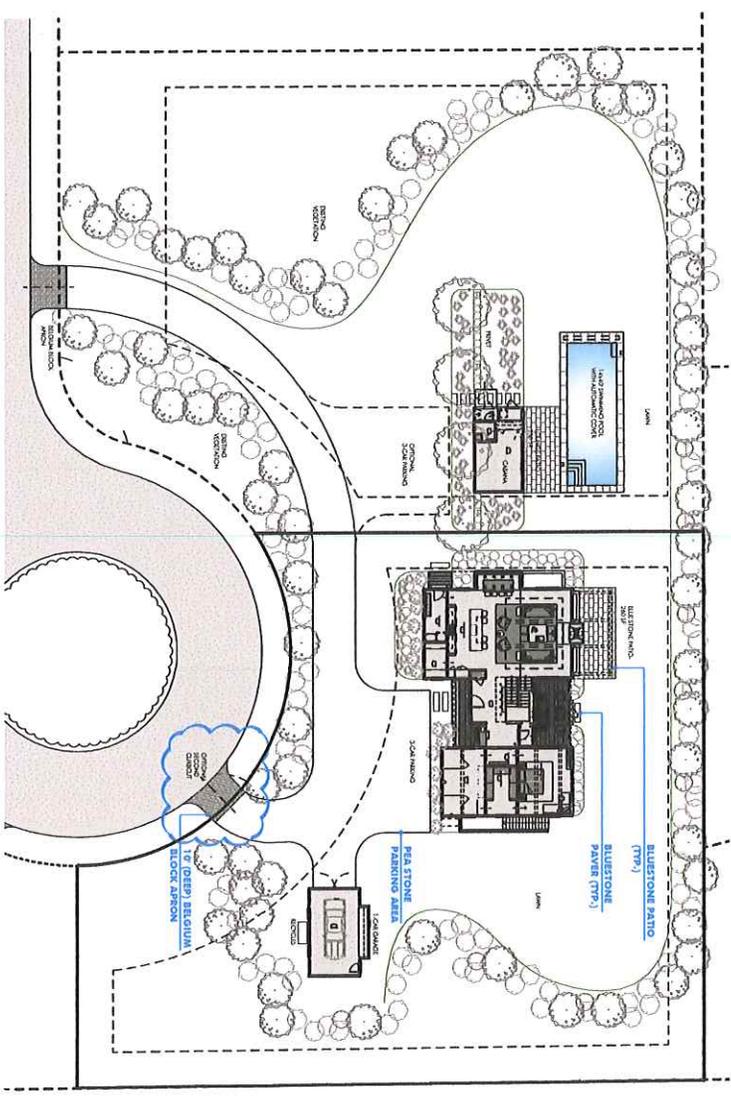

SWERTWING CIRCLE

SCALE: 1/8" = 1'-0"

RECEIVED  
AUG 25 2020  
BY



**PROJECT**  
**CANNONSBRURY**  
4 SWERTWING CIRCLE  
NANTUCKET, MASSACHUSETTS 02543

**OWNER**  
CANNONSBRURY HOLDINGS 2, LLC  
125 NANTUCKET PARKWAY, SUITE 201  
NANTUCKET, MASSACHUSETTS 02543

**ARCHITECT**  
WORKSHOP / P/O  
37 WALDEN AVENUE, NANTUCKET, MASSACHUSETTS 02543  
TEL: 508.339.1111 FAX: 508.339.1113



**HDC SUBMISSION**

**DRAWING INFO**  
DATE: AUGUST 18, 2020  
SCALE: 1/8" = 1'-0"

**REVISIONS**


**HDC.01**



**HISTORIC DISTRICT COMMISSION**  
2 Fairgrounds Road  
Nantucket, Massachusetts 02554

Telephone: 508.325.7587  
Email: [hdcsubmissions@nantucket-ma.gov](mailto:hdcsubmissions@nantucket-ma.gov)

COMMISSIONERS

Ray Pohl  
Chairman

Diane Coombs  
Vice-Chairman

Val Oliver

Abigail Camp

John McLaughlin

ASSOCIATE  
COMMISSIONERS

Stephen Welch

TJ Watterson

Jesse Dutra

STAFF

Cathy Flynn  
Land Use Specialist  
[cflynn@nantucket-ma.gov](mailto:cflynn@nantucket-ma.gov)

**Waiver of the HDC 10 Day Hearing Requirement**

I MIRIOS CAVALA AHERN  
AS AGENT FOR CANNON BURY W HOUSING 2, LLC  
STREET ADDRESS 6 SWEET WING CIRCLE  
MAP/PARCEL 74 - 27

UNDERSTAND THAT THE ABOVE REFERENCED APPLICATION SUBMITTED ON  
8-25-2020

WILL NOT BE REVIEWED BY THE HISTORIC DISTRICT COMMISSION, DUE TO THE  
COVID-19 PANDEMIC, WITHIN THE 10 DAY PERIOD AS REQUIRED BY:

**SECTION 8 of the HDC enabling legislation: ... The Commission shall meet  
within ten (10) days of the receipt of an application for a certificate of  
appropriateness or permit for removal...**

AND I AGREE TO A WAIVER OF THE ABOVE MENTIONED REQUIREMENT.

Miriam Aherne 8-25-2020  
Signature Date



REQUIRED WITH ALL APPLICATIONS:

- ✓
- ✓
1. **Completed Application Form:** Description of ALL work must be indicated on application form.
2. **Property Owner's Signature:** Current owner's signature preferred; if the agent is signing the application written authorization from the owner (letter, fax, email) must be provided.
3. **Application Fee:** See back of application for fee schedule or call the office.
4. **Locus Map (4 copies):** Location Map must include north arrow, parcel boundaries, primary and secondary streets. (Town GIS Map Site) <https://www.nantucket-ma.gov/151/GIS-Maps>
5. **Site Plan (4 Copies):** must include the following: lot dimensions, north arrow, all existing structures, proposed work (highlighted) with dimension to lot lines, scale, driveway, grade changes, and *placement of HVAC units, electrical boxes, fuel tanks, etc.*
6. **8-1/2" x 11" Copies of ALL Application Materials:** Must include the following: application form (reduced 64%), locus map, plot plan, all elevations and floor plans, window schedule, photographs, other relevant supporting material. All material MUST BE LEGIBLE (font size no smaller than 12), collated and stapled.
7. **Photographs:** Required of ALL applications for alterations to an existing structure. Photographs must be clear and labeled with application address or contextual address.
8. **Electronic submission:** All documents submitted to the HDC office must be emailed to [hdcsubmissions@nantucket-ma.gov](mailto:hdcsubmissions@nantucket-ma.gov).

REQUIRED WHERE APPLICABLE:

- \_\_\_\_\_
- \_\_\_\_\_
- \_\_\_\_\_
- ✓
- \_\_\_\_\_
- \_\_\_\_\_
1. **Supplemental Information for Historic Buildings:** It is the applicant's responsibility to research the historical status of any and ALL buildings. Additional information may be obtained from the Nantucket Historical Association Library. If not historic, denote on application.
2. **Exterior Elevations and Floor Plans (4 copies):** Must be 1/4-inch scale and include all affected sides of the building, cardinal points (N, S, E, W), dimensions, heights, floor and ceiling heights, elevations of finished grade, window details and placement of HVAC units, electrical boxes, fuel tanks, etc. *All changes from approved or existing design must be clouded on drawing.* All material MUST BE LEGIBLE, collated and stapled. Reduced sets should maintain a font size of 12.
3. **As-Built Plans (1 copy):** of existing elevations
4. **Hardscaping Plans (4 copies):** To legible scale. This includes fences, decks, porches, arbors, retaining walls, tennis courts, swimming pool, driveways, gazebos etc. All material MUST BE LEGIBLE, collated and stapled.
5. **Topographic Map:** Must show existing and proposed grade for any change of more than one foot in height on grade. Retaining walls must be applied for separately (see hardscaping plan).
6. **Door and Window Schedule (4 copies):** Must include window type (true divided, simulated divided), number of lights, dimensions, materials, manufacturers type name and type number.
7. **I UNDERSTAND THAT A TRUE DIVIDED LIGHT WINDOW/DOOR IS DEFINED AS MULTIPLE INDIVIDUAL SINGLE PANES OF GLASS (i.e., NOT DOUBLE-PANED OR INSULATED) ASSEMBLED IN THE SASH/DOOR USING MUNTINS.**
8. **Abutter Notification Materials** – Abutters list from Assessors Office, certified mail stubs, and a copy of letter are required for all applications for changes of 1000 square feet or more except in the Nantucket Historic Core and Sconset Historic Core where the requirement for new construction is 100 square feet.
9. **Approvals from Planning Board, Zoning Board of Appeals, Conservation Commission etc.**

(initial to indicate read and understand)