

CERTIFICATE NO: _____

DATE ISSUED: _____

Application to the HISTORIC DISTRICT COMMISSION, Nantucket, Massachusetts, for a

CERTIFICATE OF APPROPRIATENESS

for structural work.

All blanks must be filled in using BLUE OR BLACK INK (no pencil) or marked N/A.

NOTE: It is strongly recommended that the applicant be familiar with the HDC guidelines, *Building with Nantucket in Mind*, prior to submittal of application. Please see other side for submittal requirements. Incomplete applications will not be reviewed by the HDC.

This is a contractual agreement and must be filled out in ink. An application is hereby made for issuance of a Certificate of Appropriateness under Chapter 395 of the Acts and Resolves of Mass., 1970, for proposed work as described herein and on plans, drawings and photographs accompanying this application and made a part hereof by reference.

The certificate is valid for three years from date of issuance. No structure may differ from the approved application. Violation may impede issuance of Certificate of Occupancy.

PROPERTY DESCRIPTION

TAX MAP N°: 74 PARCEL N°: 29
Street & Number of Proposed Work: 7 CANNONBURY LANE
Owner of record: CANNONBURY LANE HOLDINGS 1, LLC
Mailing Address: 105 NEWBURY STREET, 4TH FLOOR
BOSTON, MA 02116
Contact Phone #: _____ E-mail: _____

AGENT INFORMATION (if applicable)

Name: AHERN LLC
Mailing Address: 6 WINDY WAY NANTUCKET, MA
02554
Contact Phone #: 508-333-5138 E-mail: DESIGN@AHERNLLC.COM

FOR OFFICE USE ONLY

Date application received: _____ Fee Paid: \$ _____
Must be acted on by: _____
Extended to: _____
Approved: _____ Disapproved: _____
Chairman: _____
Member: _____
Member: _____
Member: _____
Member: _____
Notes - Comments - Restrictions - Conditions

DESCRIPTION OF WORK TO BE PERFORMED

See reverse for required documentation.

- New Dwelling Addition Garage Driveway/Apron Commercial Historical Renovation Deck/Patio Steps Shed
- Color Change Fence Gate Hardscaping Move Building Demolition Revisions to previous Cert. No. _____
- Pool (Zoning District SR20) Roof Other _____

Size of Structure or Addition: Length: 32' Sq. Footage 1st floor: _____ Decks/Patio: Size: 270 SF 1st floor 2nd floor
Width: 16' Sq. Footage 2nd floor: _____ Size: 100 SF 1st floor 2nd floor
Sq. Footage 3rd floor: _____ 370 SF

Difference between existing grade and proposed finish grade: North _____ South _____ East _____ West _____
Height of ridge above final finish grade: North _____ South _____ East _____ West _____

Additional Remarks

Historic Name: _____
Original Date: _____
Original Builder: _____
Is there an HDC survey form for this building attached? Yes N/A

- REVISIONS***
- 1. East Elevation
 - 2. South Elevation
 - 3. West Elevation
 - 4. North Elevation

*Cloud on drawings and submit photographs of existing elevations.

DETAIL OF WORK TO BE PERFORMED

Foundation: Height Exposed _____ Block Block Parged Brick (type) _____ Poured Concrete Piers
Masonry Chimney: Block Parged Brick (type) _____ Other _____
Roof Pitch: Main Mass _____/12 Secondary Mass _____/12 Dormer _____/12 Other _____

Roofing material: Asphalt: 3-Tab Architectural
 Wood (Type: Red Cedar, White Cedar, Shakes, etc.) _____

Fence: Height: _____
Type: _____
Length: _____

Skylights (flat only): Manufacturer _____ Rough Opening _____ Size _____ Location _____
Manufacturer _____ Rough Opening _____ Size _____ Location _____

Gutters: Wood Aluminum Copper Leaders (material) _____

Leaders (material and size): _____

Sidewall: White cedar shingles _____ Clapboard (exposure: _____ inches) Front Side
 Other _____

Trim: A. Wood Pine Redwood Cedar Other _____

B. Treatment Paint Natural to weather Other _____

C. Dimensions: Fascia _____ Rake _____ Soffit (Overhang) _____ Corner boards _____ Frieze _____

Window Casing _____ Door Frame _____ Columns/Posts: Round _____ Square _____

Windows*: Double Hung Casement All Wood Other _____

True Divided Lights (muntins), single pane SDL's (Simulated Divided Lights) Manufacturer _____

Doors* (type and material): TDL SDL Front _____ Rear _____ Side _____

Garage Door(s): Type _____ Material _____

Hardscape materials: Driveways PEA STONE Walkways BLUE STONE Walls _____

* Note: Complete door and window schedules are required. PATIO: BLUE STONE APRON: BELGIUM BLOCK

COLORS

Sidewall _____ Clapboard (if applicable) _____ Roof _____
Trim _____ Sash _____ Doors _____
Deck _____ Foundation _____ Fence _____ Shutters _____

* Attach manufacturer's color samples if color is not from HDC approval list.

I hereby authorize the agent named above to act on my behalf to make changes in the specifications or the plans contained in this application in order to bring the application into compliance with the HDC guidelines. I hereby agree to abide by and comply with the terms and conditions of this application. I hereby agree that the submission of any revisions to this application will initiate a new sixty-day review period.

Date 8-25-2020 Signature of owner of record _____

Signed under penalties of perjury _____



HISTORIC DISTRICT COMMISSION

2 Fairgrounds Road
Nantucket, Massachusetts 02554

Telephone: 508.325.7587
Email: hcdsubmissions@nantucket-ma.gov

COMMISSIONERS

Ray Pohl
Chairman

Diane Coombs
Vice-Chairman

Val Oliver

Abigail Camp

John McLaughlin

ASSOCIATE COMMISSIONERS

Stephen Welch

TJ Watterson

Jesse Dutra

STAFF

Cathy Flynn
Land Use Specialist
cflynn@nantucket-ma.gov

Waiver of the HDC 10 Day Hearing Requirement

I MIROSCANA AHERU
AS AGENT FOR CANNONBURY LN HOLDINGS I, LLC
STREET ADDRESS 7 CANNONBURY LN
MAP/PARCEL 74 / 29

UNDERSTAND THAT THE ABOVE REFERENCED APPLICATION SUBMITTED ON
8-25-2020

WILL NOT BE REVIEWED BY THE HISTORIC DISTRICT COMMISSION, DUE TO THE COVID-19 PANDEMIC, WITHIN THE 10 DAY PERIOD AS REQUIRED BY:

SECTION 8 of the HDC enabling legislation: ... The Commission shall meet within ten (10) days of the receipt of an application for a certificate of appropriateness or permit for removal...

AND I AGREE TO A WAIVER OF THE ABOVE MENTIONED REQUIREMENT.

[Signature] 8-25-2020
Signature Date



REQUIRED WITH ALL APPLICATIONS:

1. Completed Application Form: Description of ALL work must be indicated on application form.
2. Property Owner's Signature: Current owner's signature preferred; if the agent is signing the application written authorization from the owner (letter, fax, email) must be provided.
3. Application Fee: See back of application for fee schedule or call the office.
4. Locus Map (4 copies): Location Map must include north arrow, parcel boundaries, primary and secondary streets. (Town GIS Map Site) <https://www.nantucket-ma.gov/151/GIS-Maps>
5. Site Plan (4 Copies): must include the following: lot dimensions, north arrow, all existing structures, proposed work (highlighted) with dimension to lot lines, scale, driveway, grade changes, and *placement of HVAC units, electrical boxes, fuel tanks, etc.*
6. 8-1/2" x 11" Copies of ALL Application Materials: Must include the following: application form (reduced 64%), locus map, plot plan, all elevations and floor plans, window schedule, photographs, other relevant supporting material. All material MUST BE LEGIBLE (font size no smaller than 12), collated and stapled.
7. Photographs: Required of ALL applications for alterations to an existing structure. Photographs must be clear and labeled with application address or contextual address.
8. Electronic submission: All documents submitted to the HDC office must be emailed to hdcsubmissions@nantucket-ma.gov.

REQUIRED WHERE APPLICABLE:

1. Supplemental Information for Historic Buildings: It is the applicant's responsibility to research the historical status of any and ALL buildings. Additional information may be obtained from the Nantucket Historical Association Library. If not historic, denote on application.
2. Exterior Elevations and Floor Plans (4 copies): Must be 1/4-inch scale and include all affected sides of the building, cardinal points (N, S, E, W), dimensions, heights, floor and ceiling heights, elevations of finished grade, window details and placement of HVAC units, electrical boxes, fuel tanks, etc. *All changes from approved or existing design must be clouded on drawing.* All material MUST BE LEGIBLE, collated and stapled. Reduced sets should maintain a font size of 12.
3. As-Built Plans (1 copy): of existing elevations
4. Hardscaping Plans (4 copies): To legible scale. This includes fences, decks, porches, arbors, retaining walls, tennis courts, swimming pool, driveways, gazebos etc. All material MUST BE LEGIBLE, collated and stapled.
5. Topographic Map: Must show existing and proposed grade for any change of more than one foot in height on grade. Retaining walls must be applied for separately (see hardscaping plan).
6. Door and Window Schedule (4 copies): Must include window type (true divided, simulated divided), number of lights, dimensions, materials, manufacturers type name and type number.
7. **I UNDERSTAND THAT A TRUE DIVIDED LIGHT WINDOW/DOOR IS DEFINED AS MULTIPLE INDIVIDUAL SINGLE PANES OF GLASS (i.e., NOT DOUBLE-PANED OR INSULATED) ASSEMBLED IN THE SASH/DOOR USING MUNTINS.**
8. Abutter Notification Materials – Abutters list from Assessors Office, certified mail stubs, and a copy of letter are required for all applications for changes of 1000 square feet or more except in the Nantucket Historic Core and 'Sconset Historic Core where the requirement for new construction is 100 square feet.
9. Approvals from Planning Board, Zoning Board of Appeals, Conservation Commission etc.

(initial to indicate read and understand)



LANDSCAPE DESIGN STUDIO
 PO Box 2213, Nantucket, MA 02584
 T: (508) 333-6138 F: (508) 325-4616
 aherndesign.com

PROJECT
CANNONBURY

7 CANNONBURY LANE
 NANTUCKET MA 02554

OWNER
 CANNONBURY LANE HOLDINGS 1, LLC
 103 Newbury Street, 4th Floor
 Boston, MA 02116

ARCHITECT
 WORKSHOP / APD
 39 West 38th Street, 7th Fl., New York, NY 10018
 T: (212) 773-9172




HDC SUBMISSION
SWIMMING POOL

DRAWING INFO
 DATE: AUGUST 19, 2020
 SCALE: 1/16" = 1'-0"

REVISIONS

HDC.01

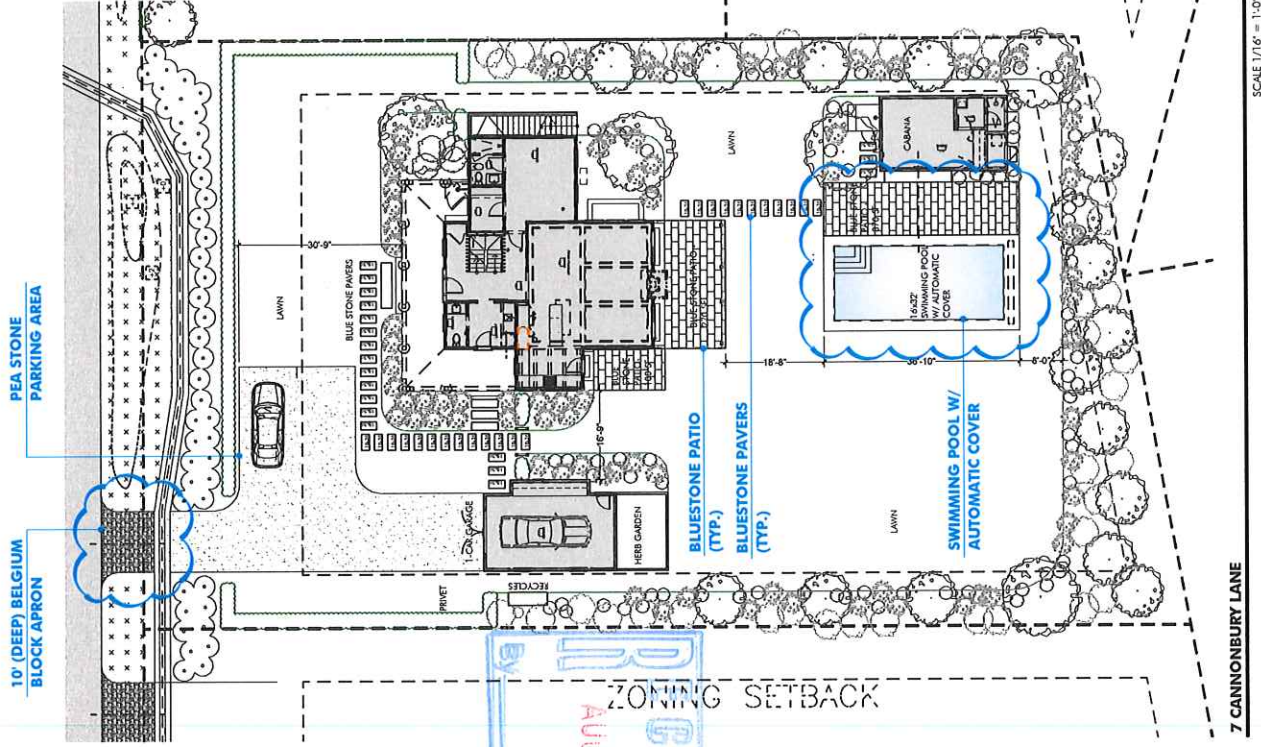

RECEIVED
 AUG 25 2020

